

Abbreviations

Terminology

AB	ANCHOR BOLT	LF	LIGHT FIXTURE
AGT	ACOUSTIC CEILING TILE	LIN	LINEAR
ADD	ADDITIVE		
ADD'L	ADDITIONAL	MATL	MATERIAL
ADJ	ADJACENT, ADJUSTABLE	MAX	MAXIMUM
A/E	ARCHITECT/ENGINEER	MDO	MEDIUM DENSITY OVERLAY PLYWOOD
AF	ABOVE FINISH FLOOR	MECH	MECHANICAL
ALUM	ALUMINUM	MEM	MEMBRANE
APPROX	APPROXIMATE	MFR	MANUFACTURER
AVG	AVERAGE	MIN	MINIMUM
		MISC	MISCELLANEOUS
		MOD BIT	MODIFIED BITUMEN
BD	BOARD		
BETW	BETWEEN	N	NORTH
BLDG	BUILDING	N/C	NOT IN CONTRACT
BLKS	BLOCKING	NOM	NOMINAL
BOT	BOTTOM	NTS	NOT TO SCALE
BRG	BEARING		
BTF	BEAT TO FIT		
BUR	BUILT-UP ROOFING	O/	OVER
BY	BOTH WAYS	OC	ON CENTER, OVERCURRENT
		OF/CI	OWNER FURNISHED # CONTRACTOR INSTALLED
CEM	CEMENT	OF/O	OWNER FURNISHED & OWNER INSTALLED
CF/CI	CONTRACTOR FURNISHED & CONTRACTOR INSTALLED	OH	OPPOSITE HAND
CHAM	CHAMFER	OPNG	OPENING
CJ	CONSTRUCTION JOINT	OPP	OPPOSITE
CLG	CEILING		
CLG/CJ	CEILING CONTROL JOINT	+/-	PLUS OR MINUS
CLKS	CAULKING	PERM	PERMANENT
CONC	CONCRETE	PLB	PLUMBING
CONT	CONTINUOUS	PNT	PAINT
CONTR	CONTRACTOR	PT	PRESERVATIVE TREATED
COR	CONTRACTING OFFICER'S REPRESENTATIVE	PTD	PAINTED
CTR	CENTER	RD	ROOF DRAIN
		REF	REFERENCE, REFER
DBL	DOUBLE	REQD	REQUIRED
DET	DETAIL	REV	REVISE, REVISION, REVERSE
DIA	DIAMETER	RL	ROOF LEADER
DIAG	DIAGONAL		
DM	DIMENSION	S	SOUTH
DS	DOWNSPOUT	SECT	SECTION
DWG	DRAWING	SGL	SINGLE
		SIM	SIMILAR
E	EAST	SM	SHEET METAL
(E)	EXISTING	SPEC	SPECIFICATION
EA	EACH, EXHAUST AIR, EXPANSION ANCHOR	SP	STAND PIPE
EF	EACH FACE, EXHAUST FAN	SQ	SQUARE
EJ	EXPANSION JOINT	STD	STANDARD
ELEV	ELEVATION	STR	STRUCTURAL
EQ	EQUAL	SURF	SURFACE
EXH	EXHAUST		
EXP	EXPANSION EXPOSED	TEMP	TEMPORARY
EXT	EXTERIOR	THRU	THROUGH
		TYP	TYPICAL
FIN	FINISHED	UNFIN	UNFINISHED
FLR	FLOOR	UNLESS OTHERWISE NOTED	
		VB	VAPOR BARRIER
GA	GAUGE	VERT	VERTICAL
GAL	GALVANIZED		
GR	GRADE		
GAB	GYPSPUM WALL BOARD		
HGT	HEIGHT, HIGH	A	WEST
HORIZ	HORIZONTAL	W	WITH
		WD	WOOD
		WF	WIDE FLANGE
INCL	INCLUDE(D)	W/O	WITHOUT
INSUL	INSULATION	WP	WEATHER PROOF/WATERPROOF
INT	INTERIOR		

Units of Measure

FF	FOOT FEET	MIN	MINIMUM
N	NOISE	MAX	MAXIMUM
GA	GAUGE	PSF	POUNDS PER SQUARE FOOT
LB	POUNDS	PSI	POUNDS PER SQUARE INCH
LF	LINEAR FEET	SF	SQUARE FOOT
		SQ IN	SQUARE INCHES
		SQ SQ	SQUARE 100 SF OF ROOFING SURFACE

Sheet Index

T1	COVER SHEET, ABBREVIATIONS, SYMBOLS, AND GENERAL NOTES
A1	ROOF PLAN, GENERAL ROOF NOTES & DETAILS
A2	ROOF DETAILS & PHOTOGRAPHS

General Notes

- THESE DRAWINGS ARE INTENDED TO PROVIDE A GENERAL DESCRIPTION OF THE INTENDED SCOPE OF WORK AND SHOULD BE REVIEWED FOR INTENT AS WELL AS SPECIFIC INFORMATION. IT IS THE SOLE RESPONSIBILITY OF THE CONTRACTOR TO EXECUTE THE WORK IN ACCORDANCE WITH GENERALLY ACCEPTED STANDARDS OF QUALITY CONSTRUCTION TO PROVIDE A COMPLETE PROJECT, FULLY USABLE FOR ITS INTENDED PURPOSE.
- FIELD VERIFY ALL RELEVANT DIMENSIONS AND EXISTING CONDITIONS. NOTIFY THE ARCHITECT IN WRITING PRIOR TO THE START OF ANY WORK ON ANY ERRORS, OMISSIONS, OR DIFFERING CONDITIONS.
- CONTRACTOR TO PROTECT ALL EXISTING CONSTRUCTION TO REMAIN AND SHALL REPAIR OR REPLACE WITH NEW TO THE SATISFACTION OF THE OWNER, ANY ITEM OR MATERIAL DAMAGED DURING EXECUTION OF THIS WORK AT NO ADDITIONAL EXPENSE TO THE OWNER. CONTRACTOR RESPONSIBLE FOR ALL TEMPORARY BRACING & SHORING REQUIRED WHETHER SPECIFICALLY INDICATED, IMPLIED, OR AS OTHERWISE NECESSARY TO EXECUTE THE WORK.
- 1991 IBC AS ADOPTED BY THE CITY OF ELLENSBURG GOVERNS.
- CALL FOR ALL INSPECTIONS REQUIRED BY PUBLIC OFFICIALS AND AGENCIES HAVING JURISDICTION IN THE AREA OF THE PROJECT.
- WRITTEN DIMENSIONS HAVE PRECEDENCE OVER SCALED DIMENSIONS. DO NOT SCALE DRAWINGS.



Library

REPLACEMENT ROOFING

CONTRACT NO. 6295-3-C

Central Washington University
Ellensburg, Washington

Record Drawings
November 15th, 2004

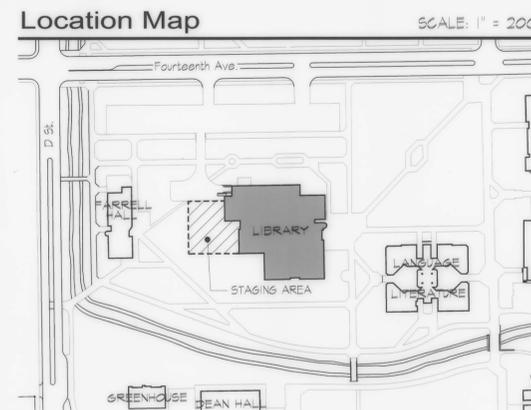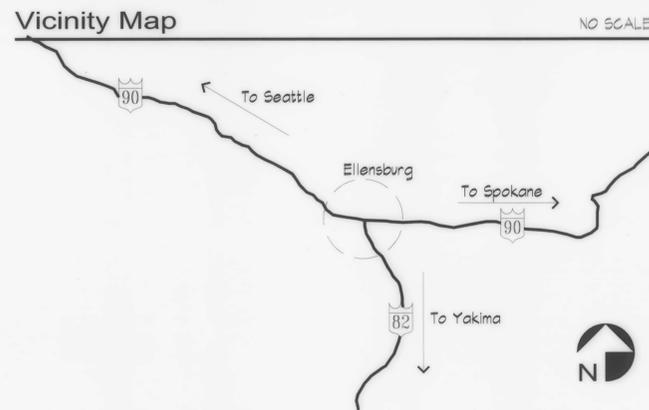

Symbols

- DETAIL (Symbol) DETAIL NUMBER SHEET NUMBER
- STRUCTURAL GRID (Symbol)
- DETAIL CUT (Symbol) DETAIL NUMBER SHEET NUMBER
- DIRECTION OF VIEW (Symbol) Photograph ID
- (Symbol) DIRECTION OF EXISTING SLOPED ROOF STRUCTURE
- (Symbol) EXISTING CONSTRUCTION TO REMAIN
- (Symbol) FLUID-APPLIED WATERPROOFING
- (Symbol) EXISTING STANDING-BEAM COR-TEN METAL ROOFING
- (Symbol) SINGLE-PLY MEMBRANE ROOFING
- (E) FPA (Symbol) EXISTING FALL PROTECTION ANCHOR
- (Symbol) VENT PIPE
- (Symbol) EXPANSION JOINT
- (Symbol) ELEV. XX SPOT ELEVATION

DRAWINGS ARE FOR REFERENCE ONLY 2025.07.28

SCHREIBER & LANE
ARCHITECTS
1221 EAST PIKE STREET
SUITE NUMBER 200
SEATTLE, WA 98122



CENTRAL WASHINGTON UNIVERSITY

LIBRARY

Replacement Roofing

Revisions:

Title Information, Abbreviations, Symbols, General Notes, Vicinity Map, Location Map, & Sheet Index

Project: 2204-3
Date: November 15, 2004

T1



CENTRAL
WASHINGTON
UNIVERSITY

LIBRARY


Replacement
Roofing

Revisions:


Roof Plan,
Photographs,
Roof Details,
& General
Roofing Notes

Project: 2204-3
Date: November 15, 2004


A1

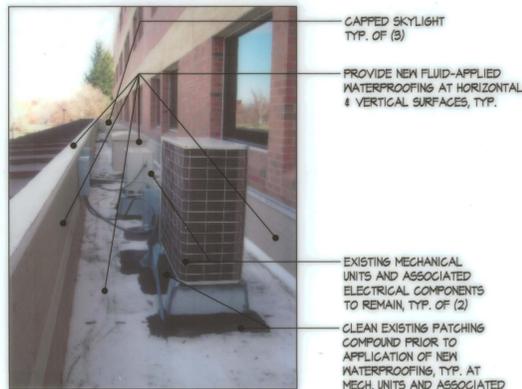

(E) Mechanical Well

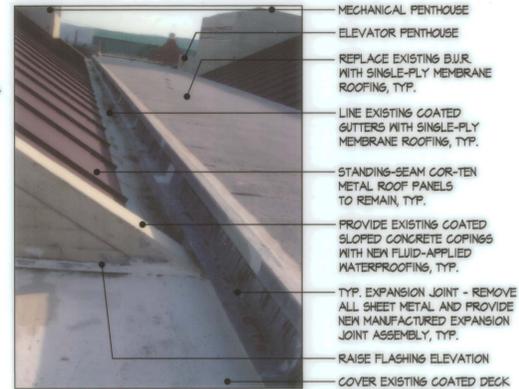

(E) Expansion Joint & B.U.R.

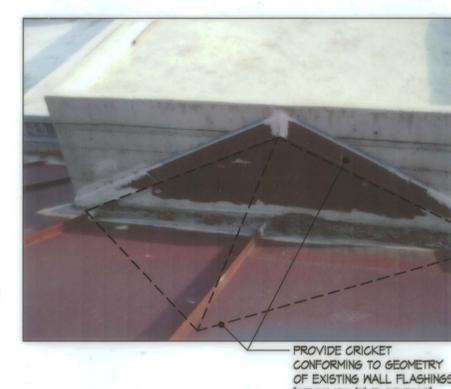


(E) Flashing @ Elev. Penthouse




(E) Roof @ Mech. Penthouse



(E) Gutter & Coping

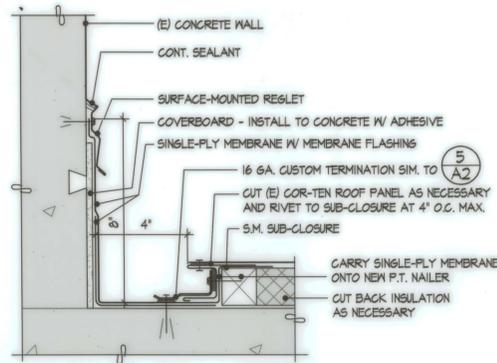


A. Sidewall Termination

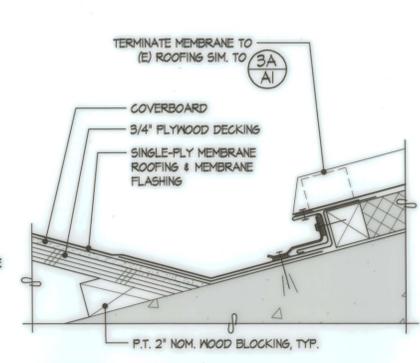

B. Interface of (E) Roofing w/ New Cricket


Cricket Details

SCALE: 1-1/2" = 1'-0"

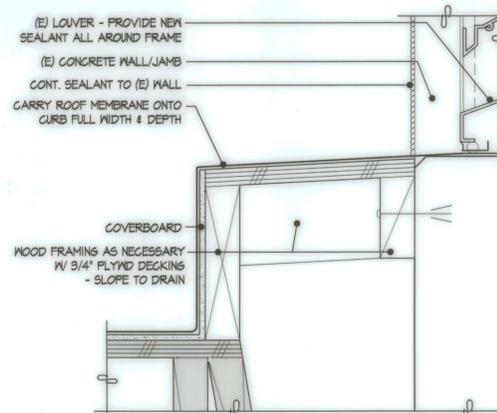

Closure at Penthouse Louver

SCALE: 3" = 1'-0"

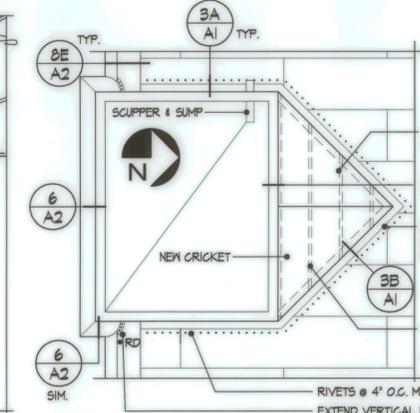


Penthouse Roof Plan

SCALE: 3/32" = 1'-0"

General Roofing Notes:

1. Prior to installing new roofing systems, Contractor to verify condition of the existing wood roof decks. Notify Architect of any damaged materials discovered. Contractor to provide unit cost for removal and replacement of damaged roof decking.
2. Prior to beginning work Contractor is responsible for demonstrating the operation of all existing roof drains, with verification by Owner's observer. Contractor is responsible for operation of all drains at completion of the project.
3. Contractor shall remove all existing flashings and trim. Provide new flashings and trim per details and specifications.
4. Mechanical equipment indications are diagrammatic in nature. Verify actual equipment sizes & locations in field.
5. No work is intended at existing standing-seam Cor-Ten metal roofing except where necessary to complete the Work. This roofing material is no longer manufactured. The Contractor shall exercise all due caution to avoid damage to panels - Provide temporary protection to extent necessary to perform Work.
6. Demolish & dispose of surface mounted heat trace from all gutters - At existing junction boxes provide blank gasketed stainless steel coverplates. Demolish and dispose of additional surface-mounted electrical materials where indicated. Patch all holes left by demolition activities.


Areas highlighted in red not part of re-roof scope. Typ.

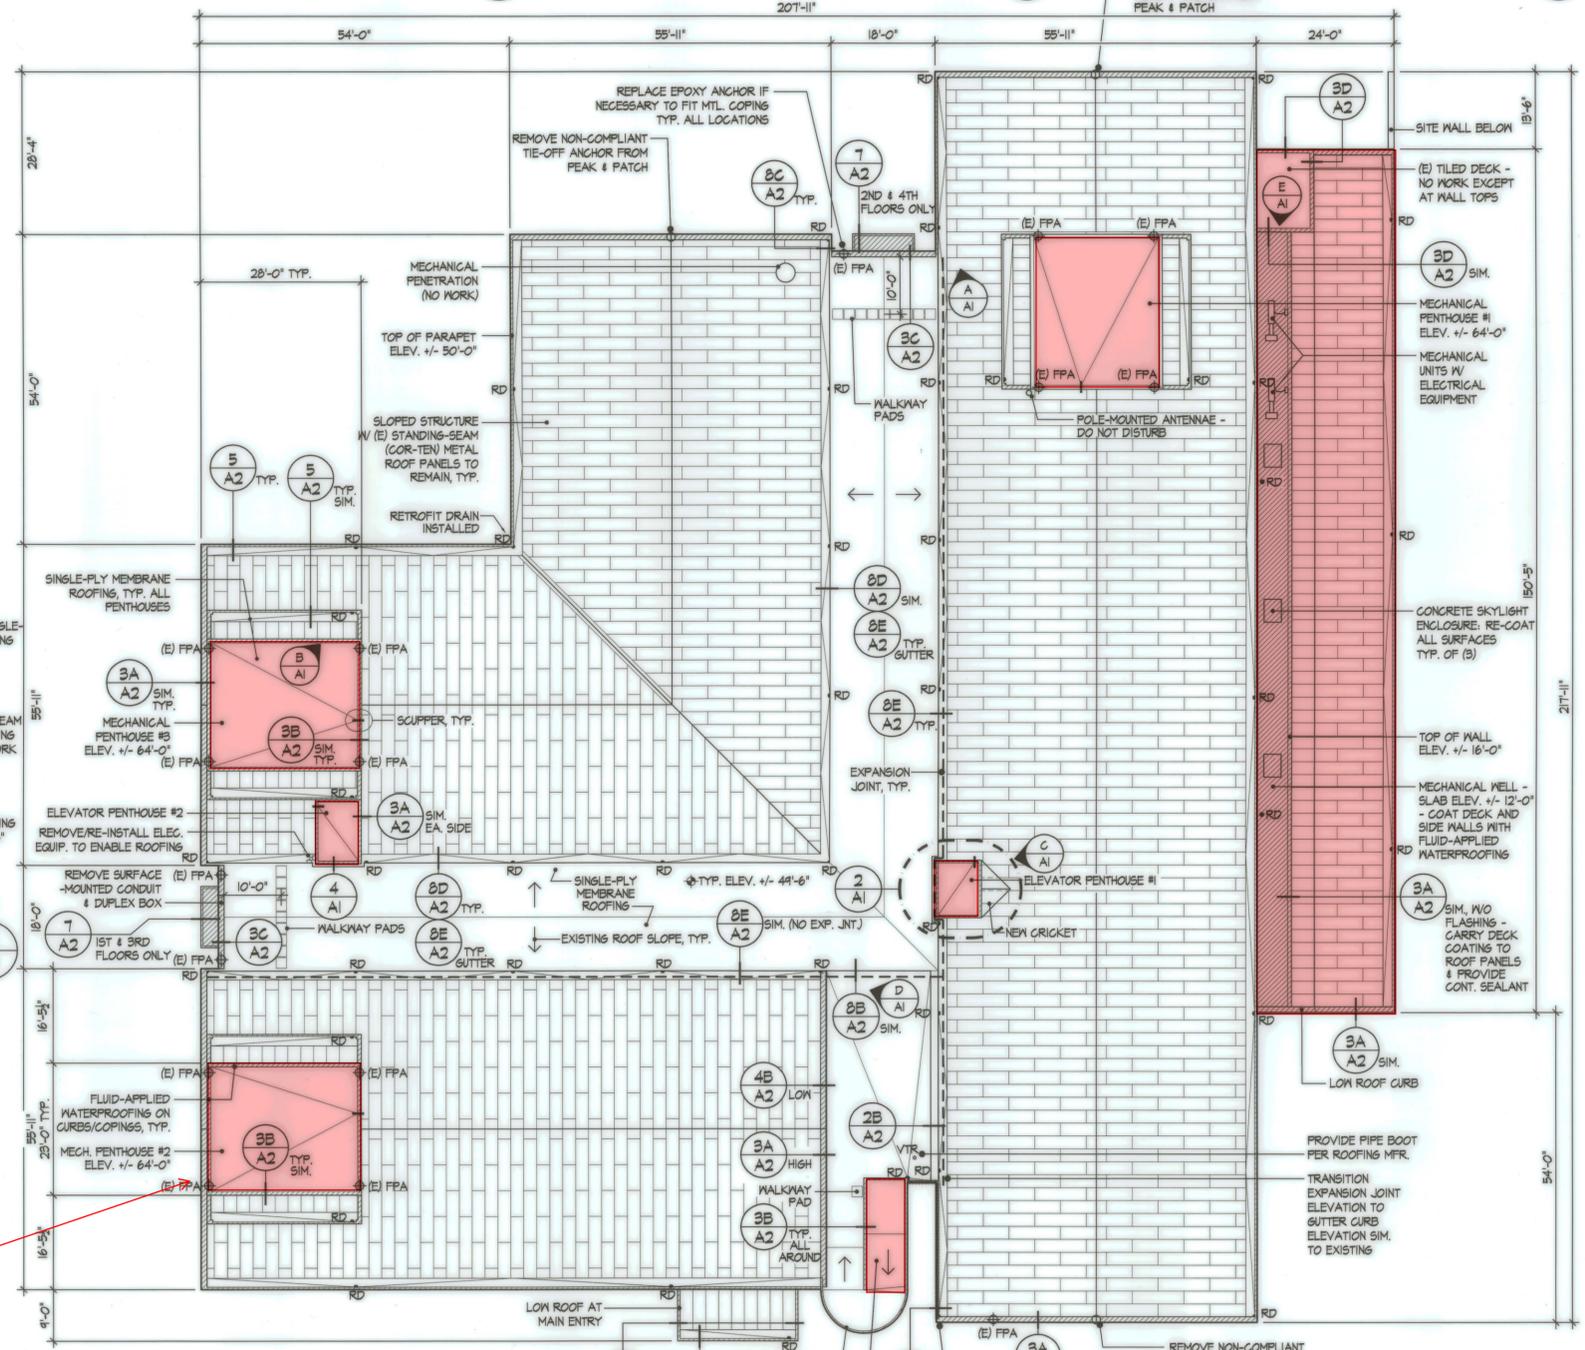

Roof Plan


SCALE: 3/32" = 1'-0"

DRAWINGS ARE FOR
REFERENCE ONLY 2025.07.28


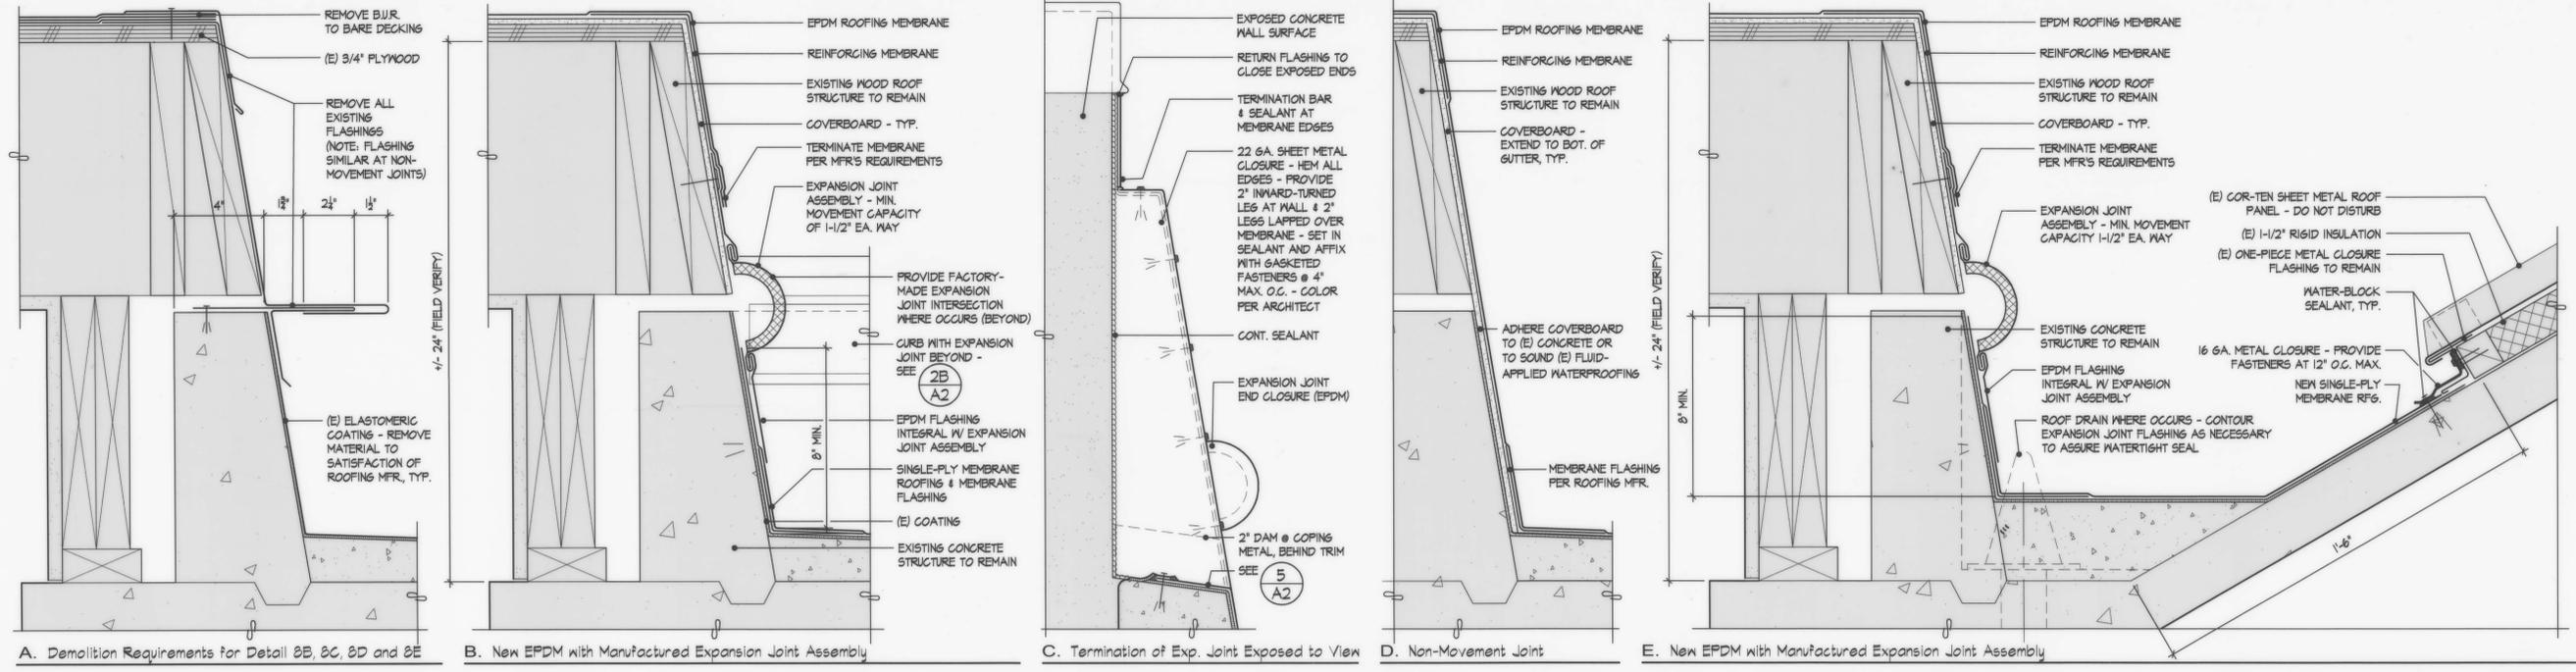


Typ. Wood Framed Roof Edges





SCALE: 3" = 1'-0"

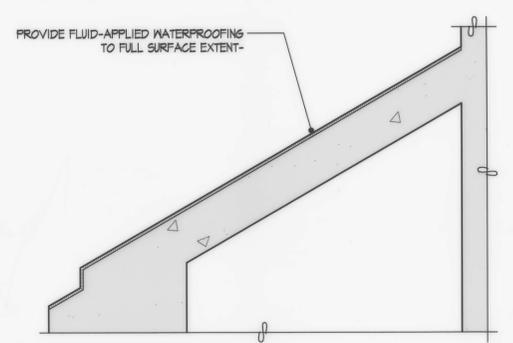


SCALE: 1-1/2" = 1'-0"

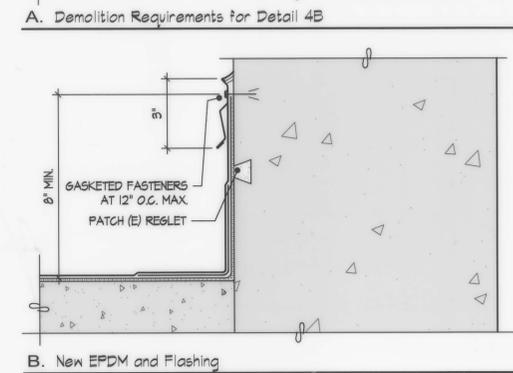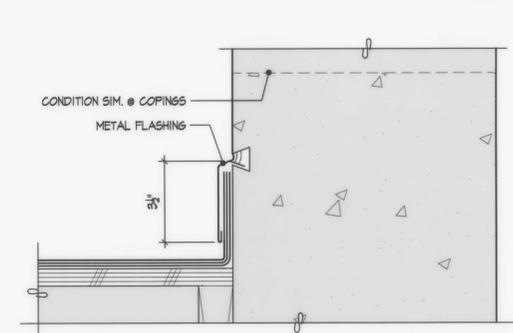


Typ. Roof/Wall Terminations
SCALE: 3" = 1'-0"

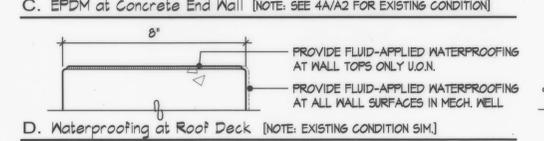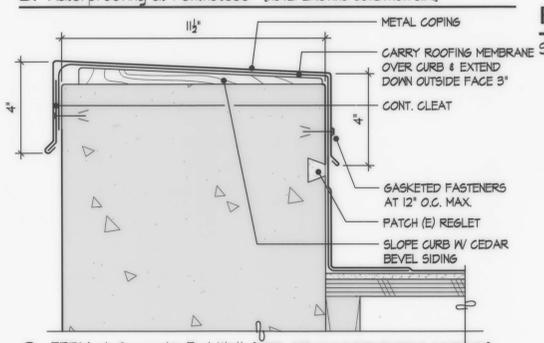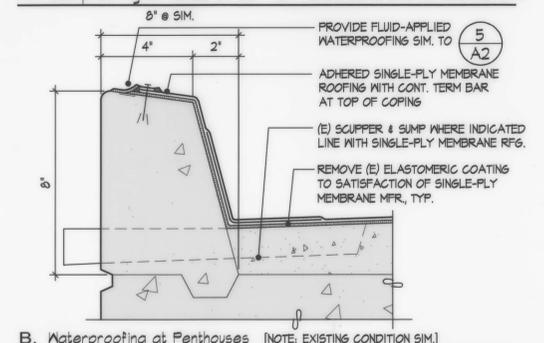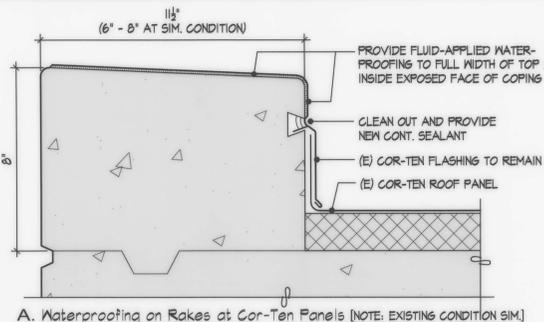


Typ. Copings
SCALE: 3" = 1'-0"

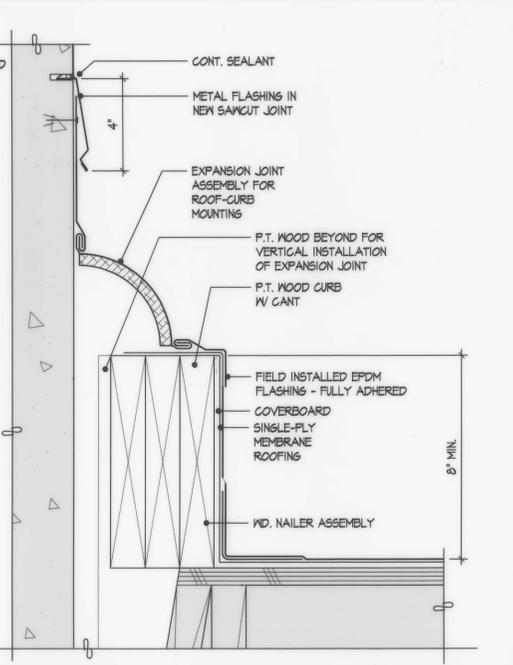


SCALE: 3" = 1'-0"

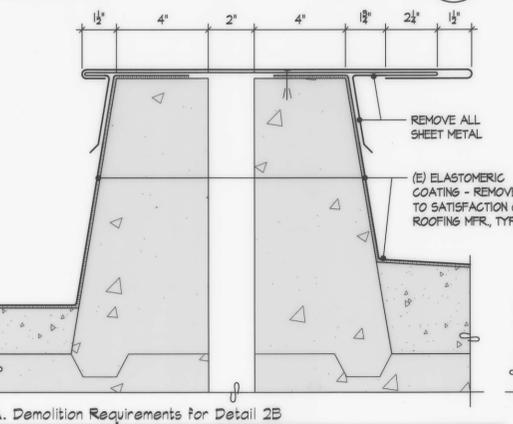

Curb-Mounted Expansion Joint Assembly
SCALE: 3" = 1'-0"

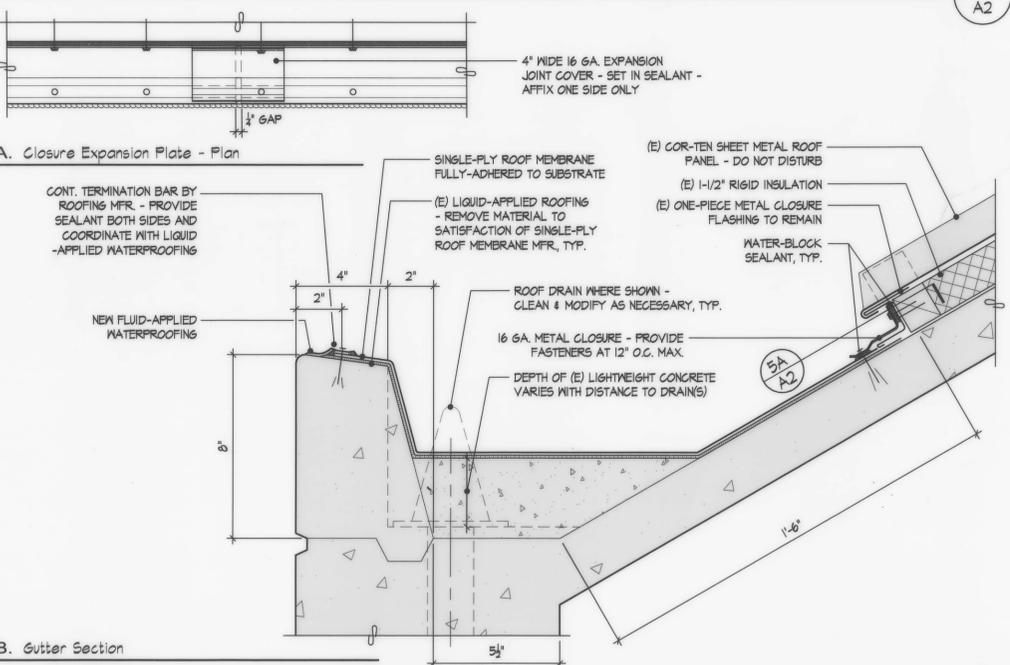

Typ. Gutter
SCALE: 3" = 1'-0"

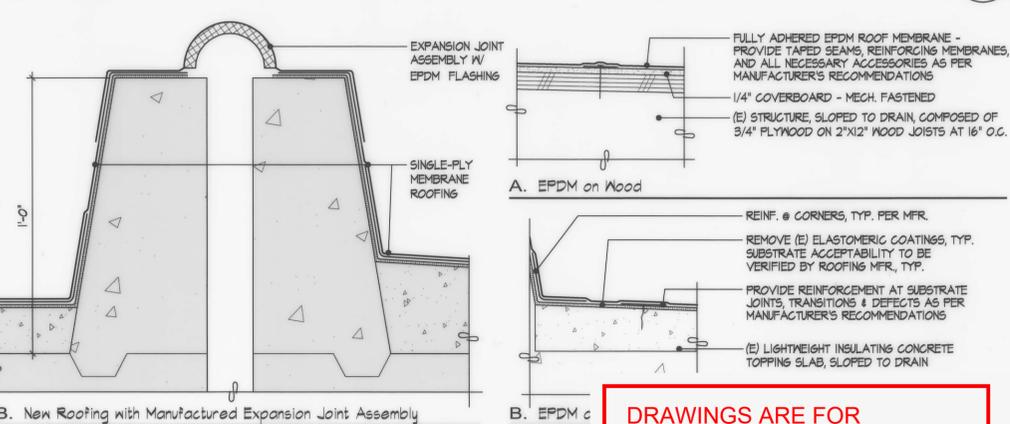

Typ. R
SCALE: 3" = 1'-0"

DRAWINGS ARE FOR REFERENCE ONLY 2025.07.28

8 A2



LIBRARY

Replacement Roofing

Revisions:

5 A2

Roof Details

Project: 2204-3
Date: November 15, 2004

A2